


AS BUILT FLOOR PLAN
SCALE 1/4" = 1'-0"

- ① 3'-0" x 8'-0" ALUMINUM STORE FRONT DBL DOORS W/ LOCK, CLEAR ANODIZED, DUAL GLAZED, TEMPERED
- Ⓐ 3'-6" x 6'-0" ALUMINUM STORE FRONT WINDOW, CLEAR ANODIZED, DUAL GLAZED, TEMPERED
- Ⓑ 4'-3" x 8'-0" ALUMINUM STORE FRONT WINDOW, CLEAR ANODIZED, DUAL GLAZED, TEMPERED
- Ⓒ 6'-0" x 1'-6" ALUMINUM STORE FRONT WINDOW, CLEAR ANODIZED, DUAL GLAZED, TEMPERED
- Ⓓ 7'-9" x 1'-6" ALUMINUM STORE FRONT WINDOW, CLEAR ANODIZED, DUAL GLAZED, TEMPERED

- PHOTOCELL DIRECTIONAL LED RECESSED LIGHT
- DIRECTIONAL LED RECESSED LIGHT
- Ⓢ LIGHT SWITCH



JUN 05 2019
EXHIBIT "A"
Page No. 2 of 5
Case No. DIR-2019-2082-CD0
June 5, 2019

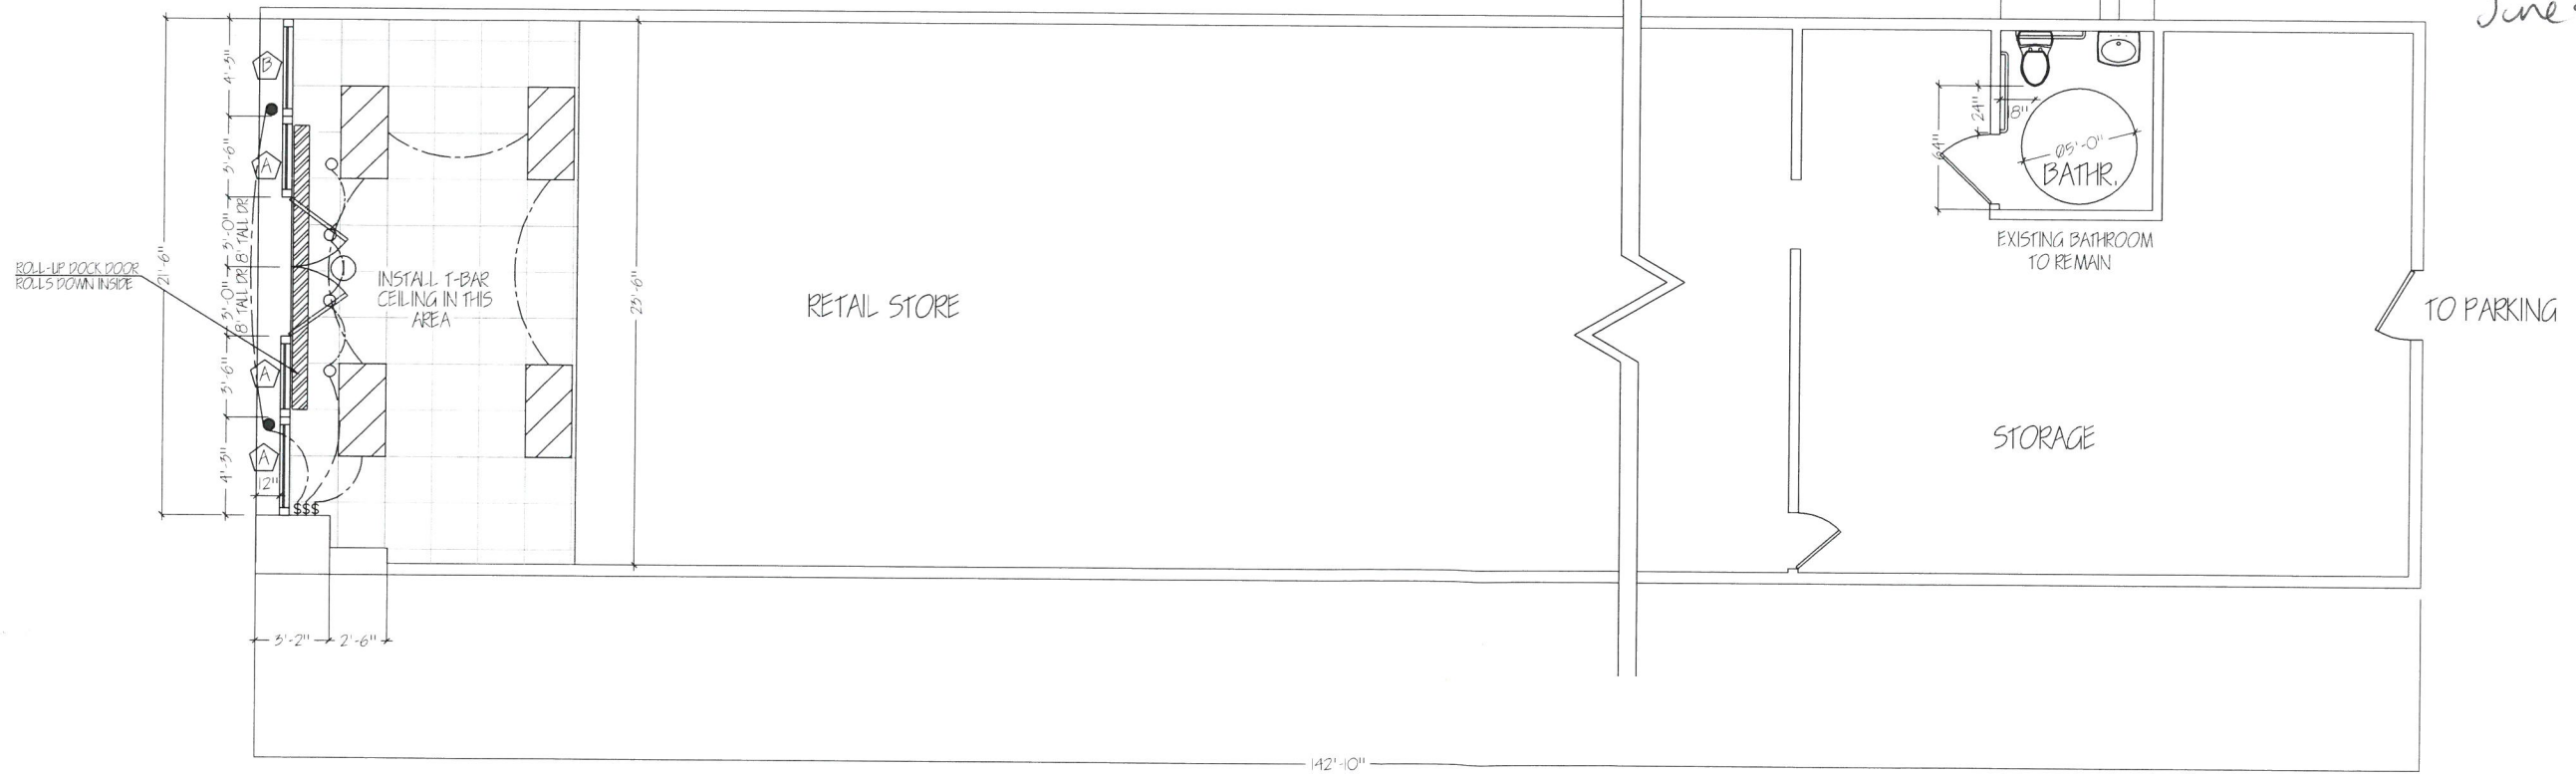

PROPOSED FLOOR PLAN
SCALE 1/4" = 1'-0"